


OLNICK SPANU
march 2006




August 1999



march 2006

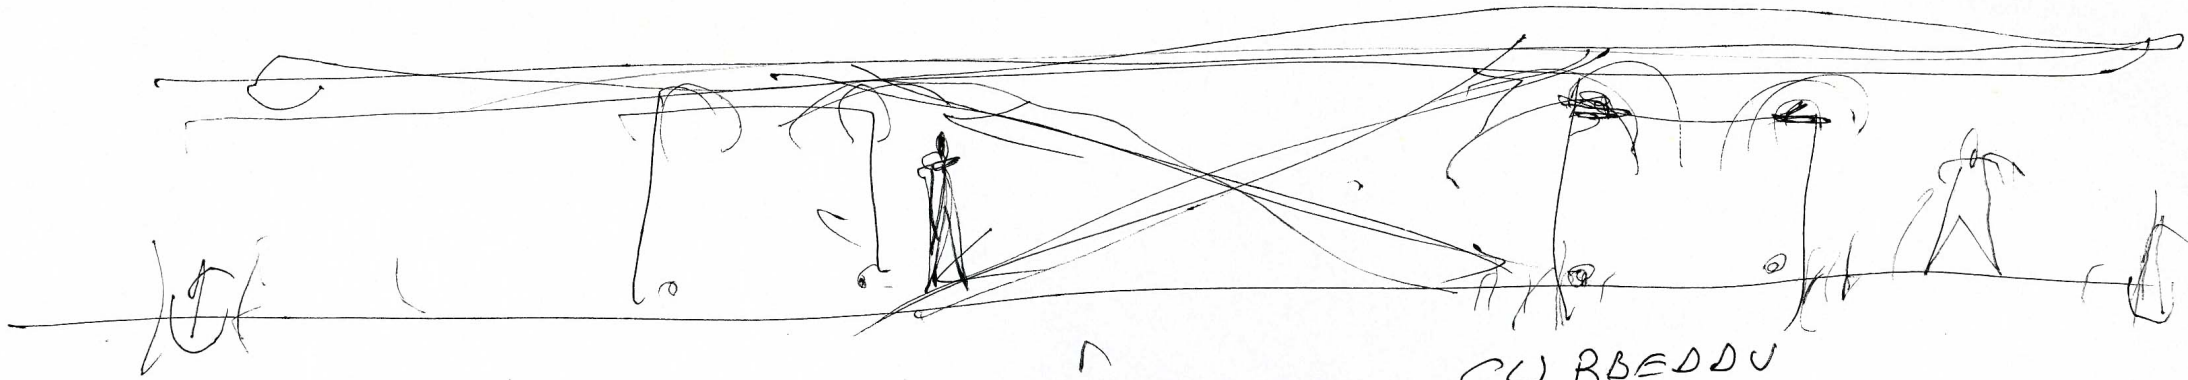


CU BBEDDU
VA ERIA CUBEDAN SPAN
ISSEY MIXAKE

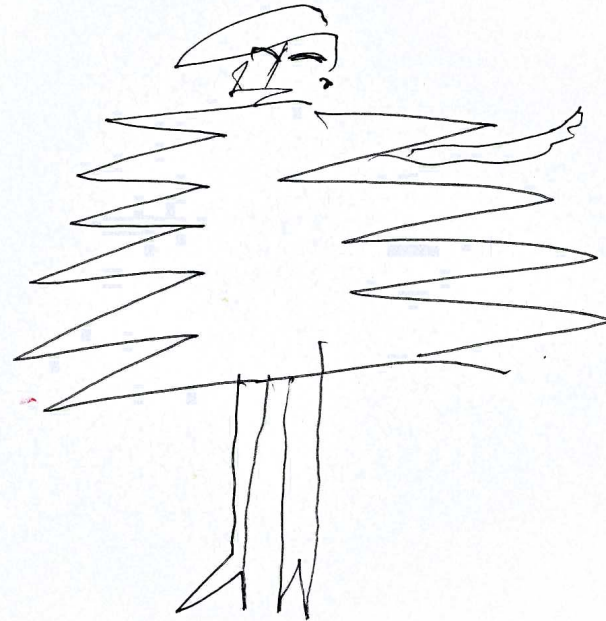

1)

Floating Roof Edge. 7


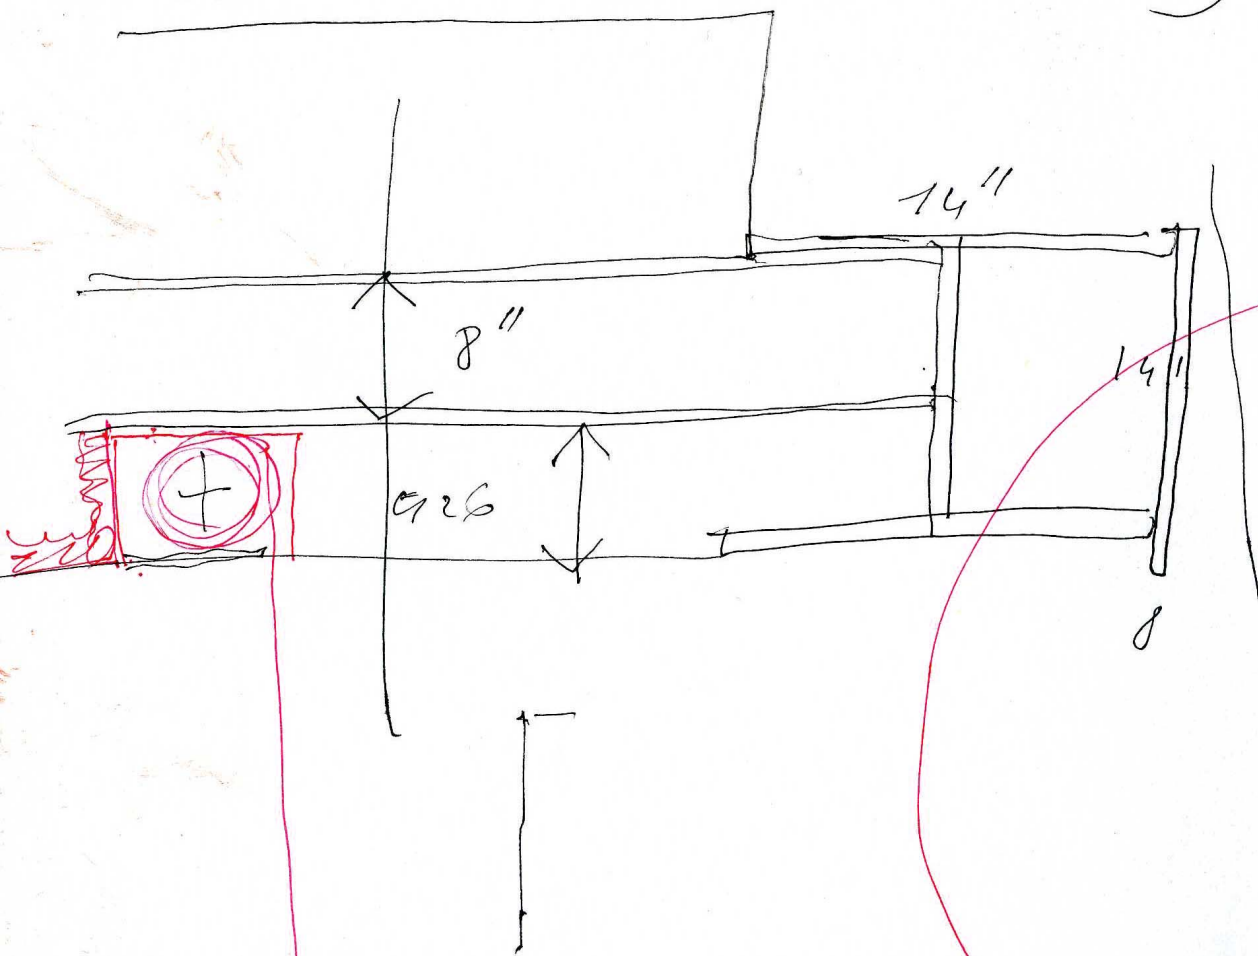



CANSEN.






14" (inches)
8" (inches)
5" 6" wide

1" = 2'5 cm
5" 12'5 cm

5" ACTUAL SCALE.

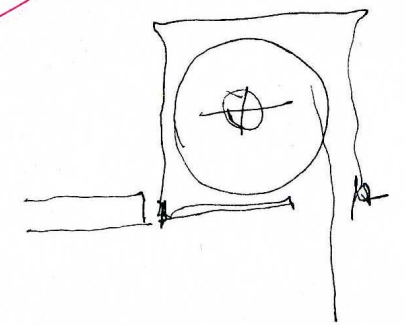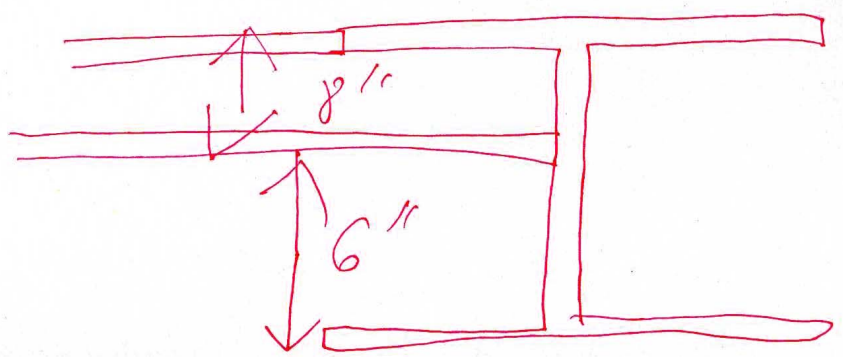

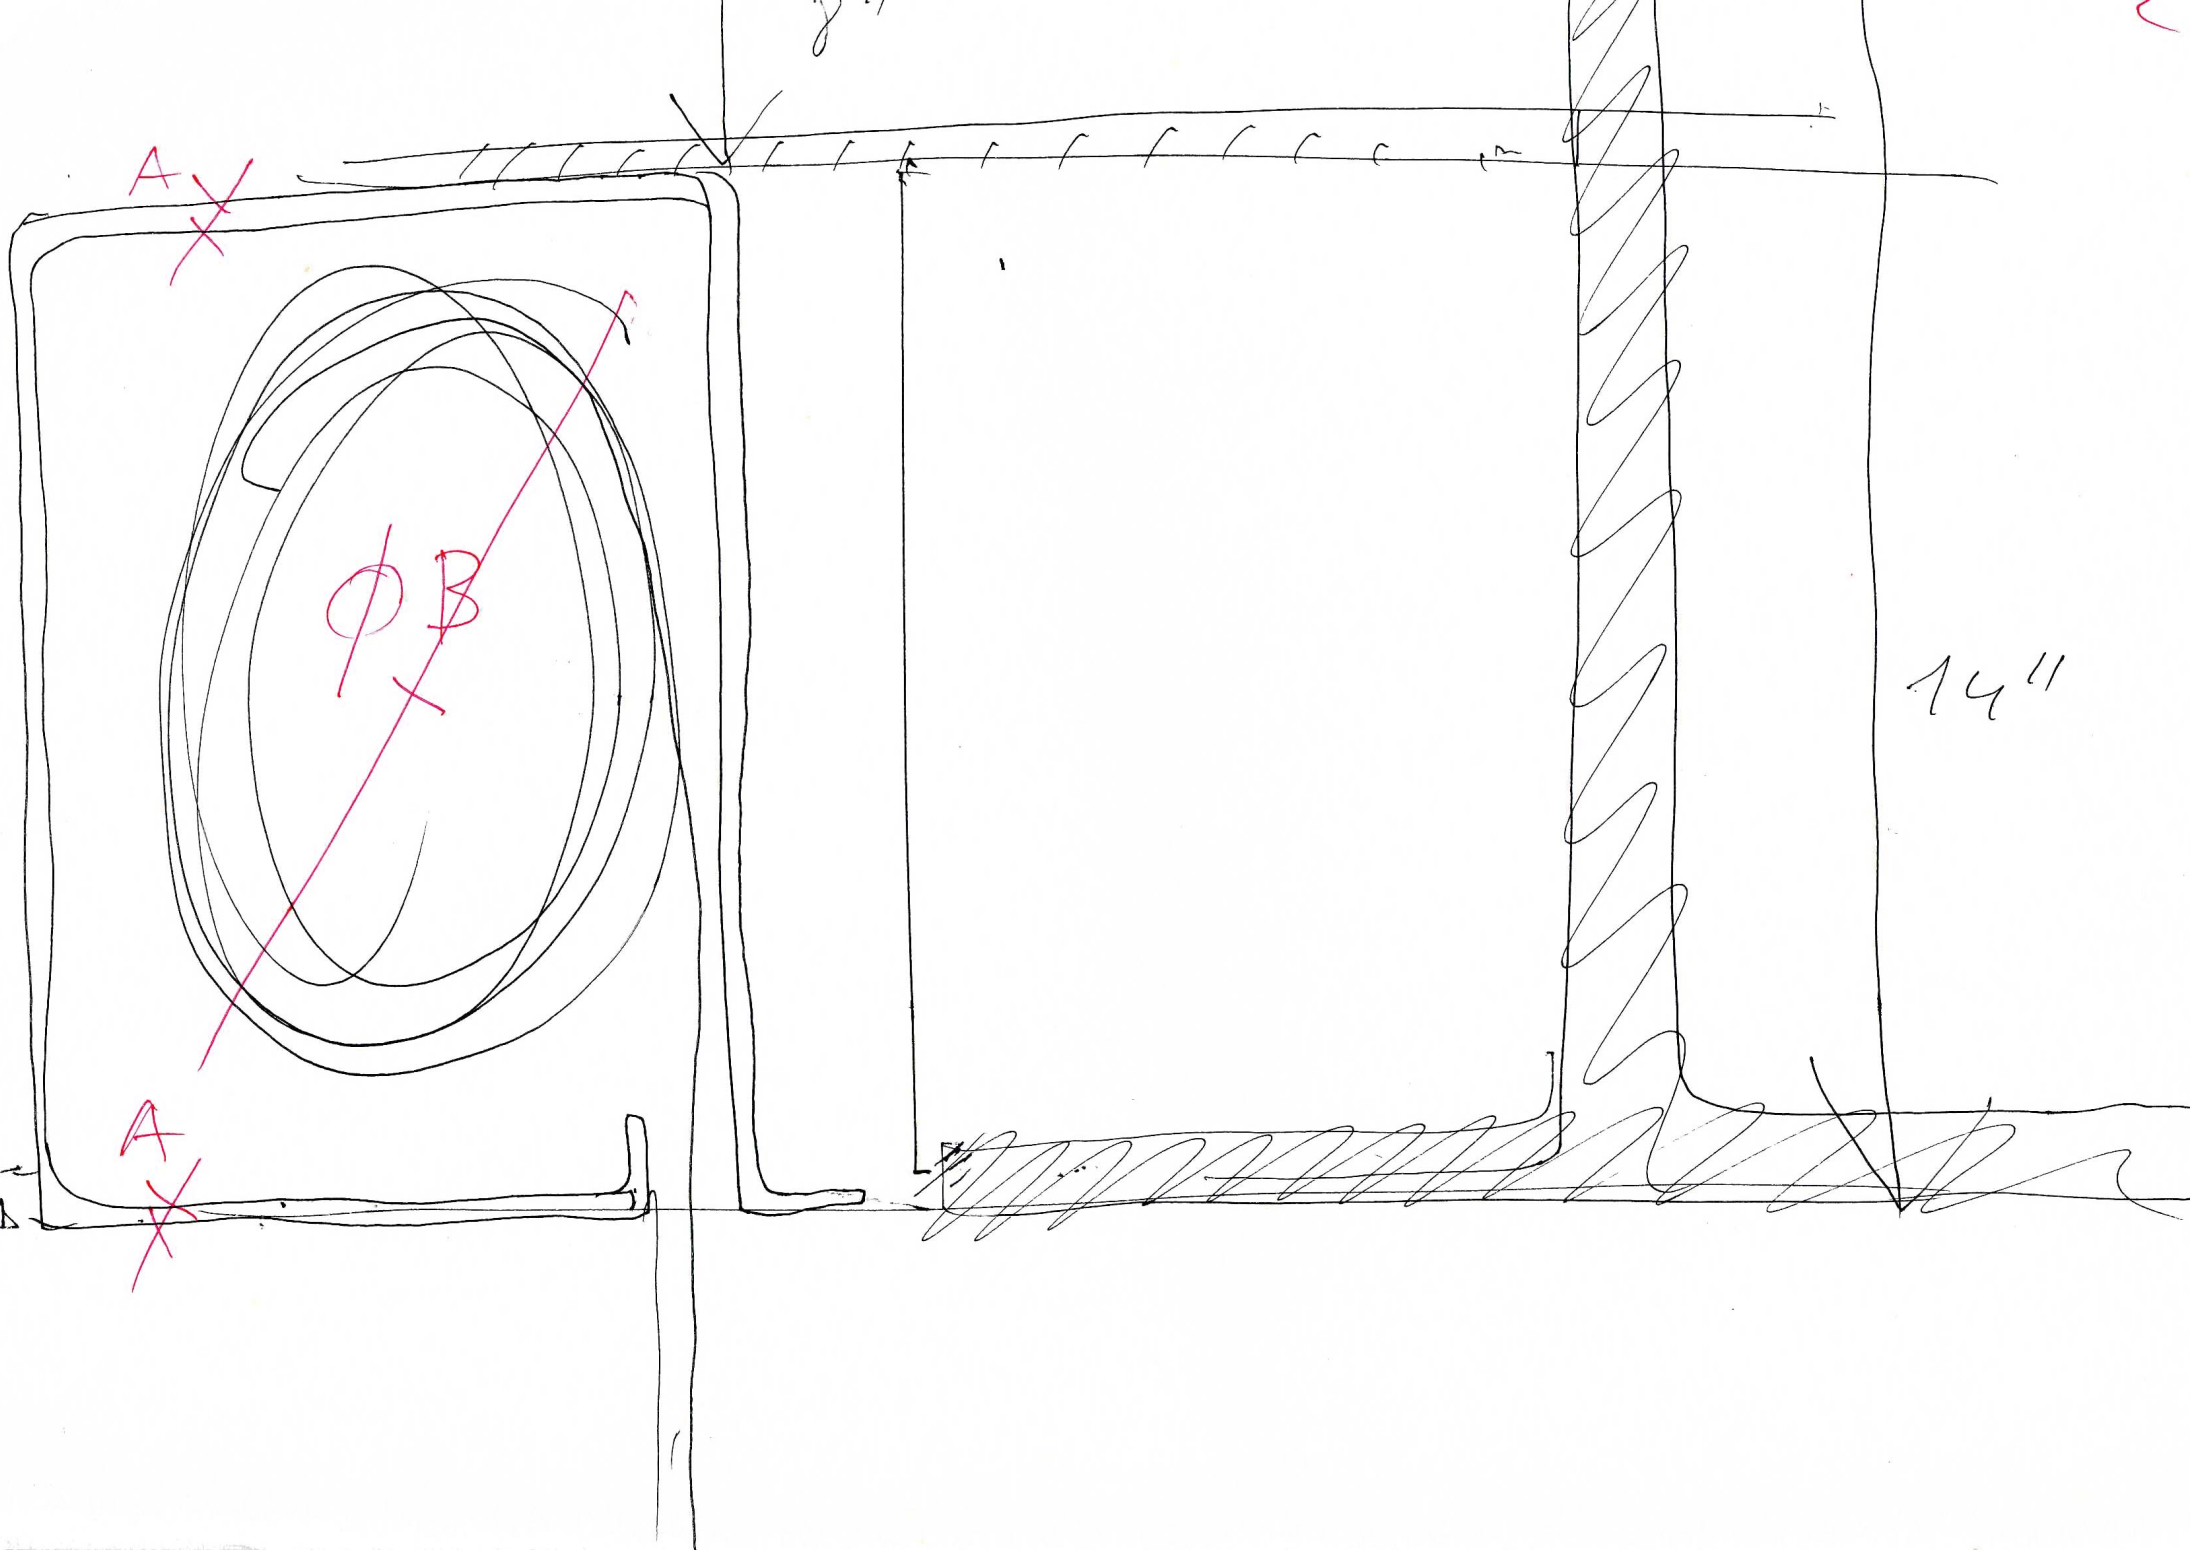


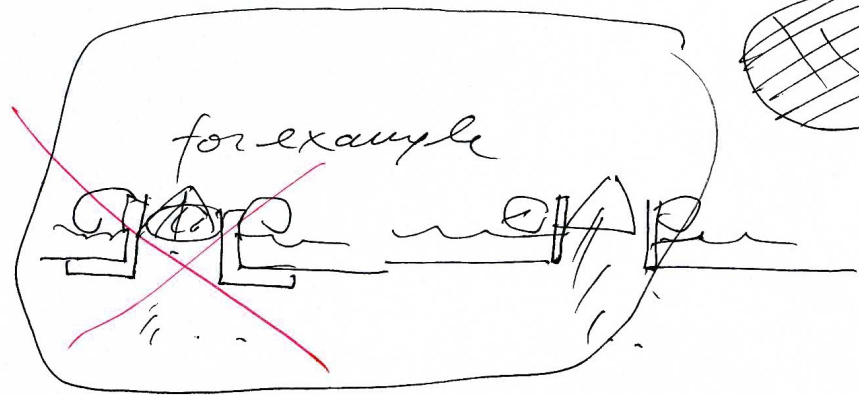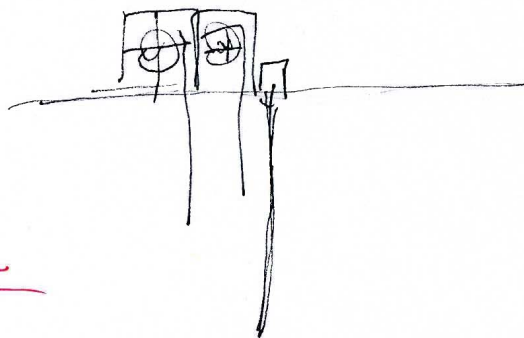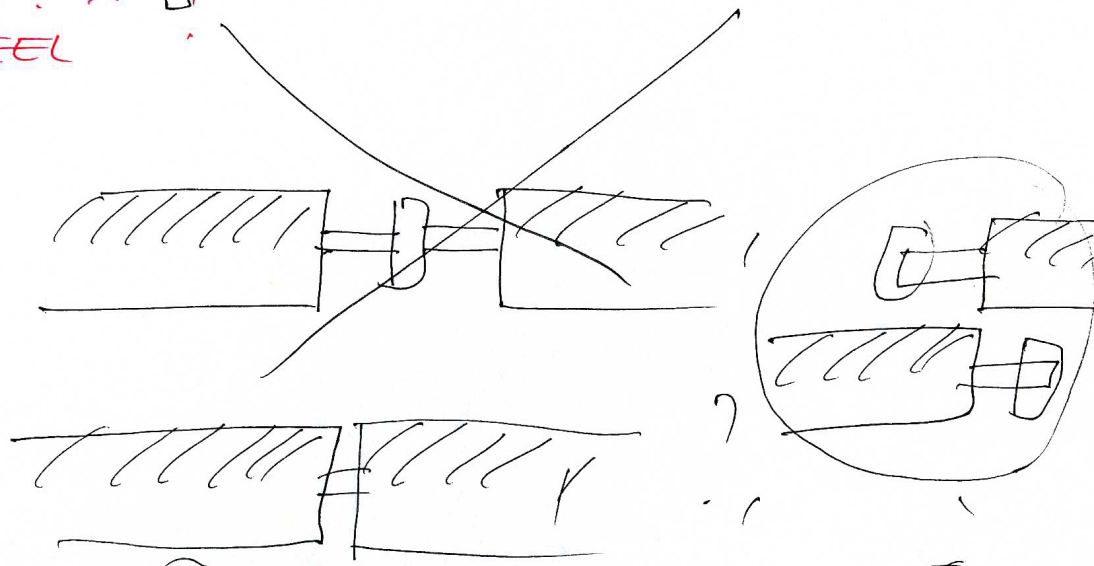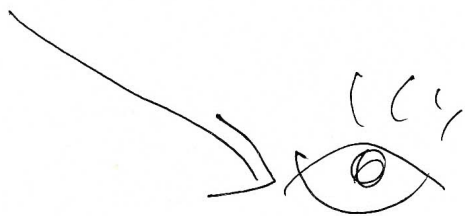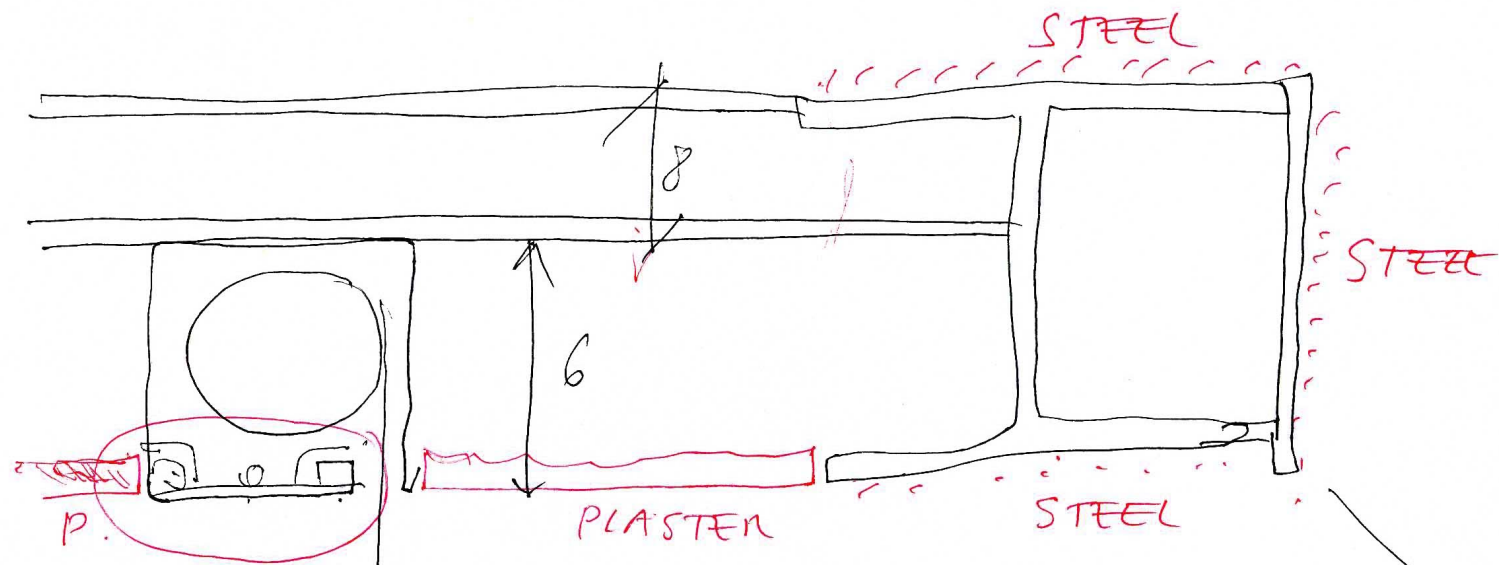

20 1st attempt @

HUNTER DOUGLAS


To know HOW MANY INCHES
with LARSEN

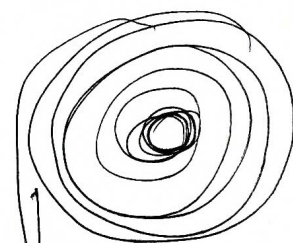







DARKNESS / SOLAR
BLACK 2 CONTROL
1 LARSEN



3 SOLAR
FILM
SCREEN.

only WEST.

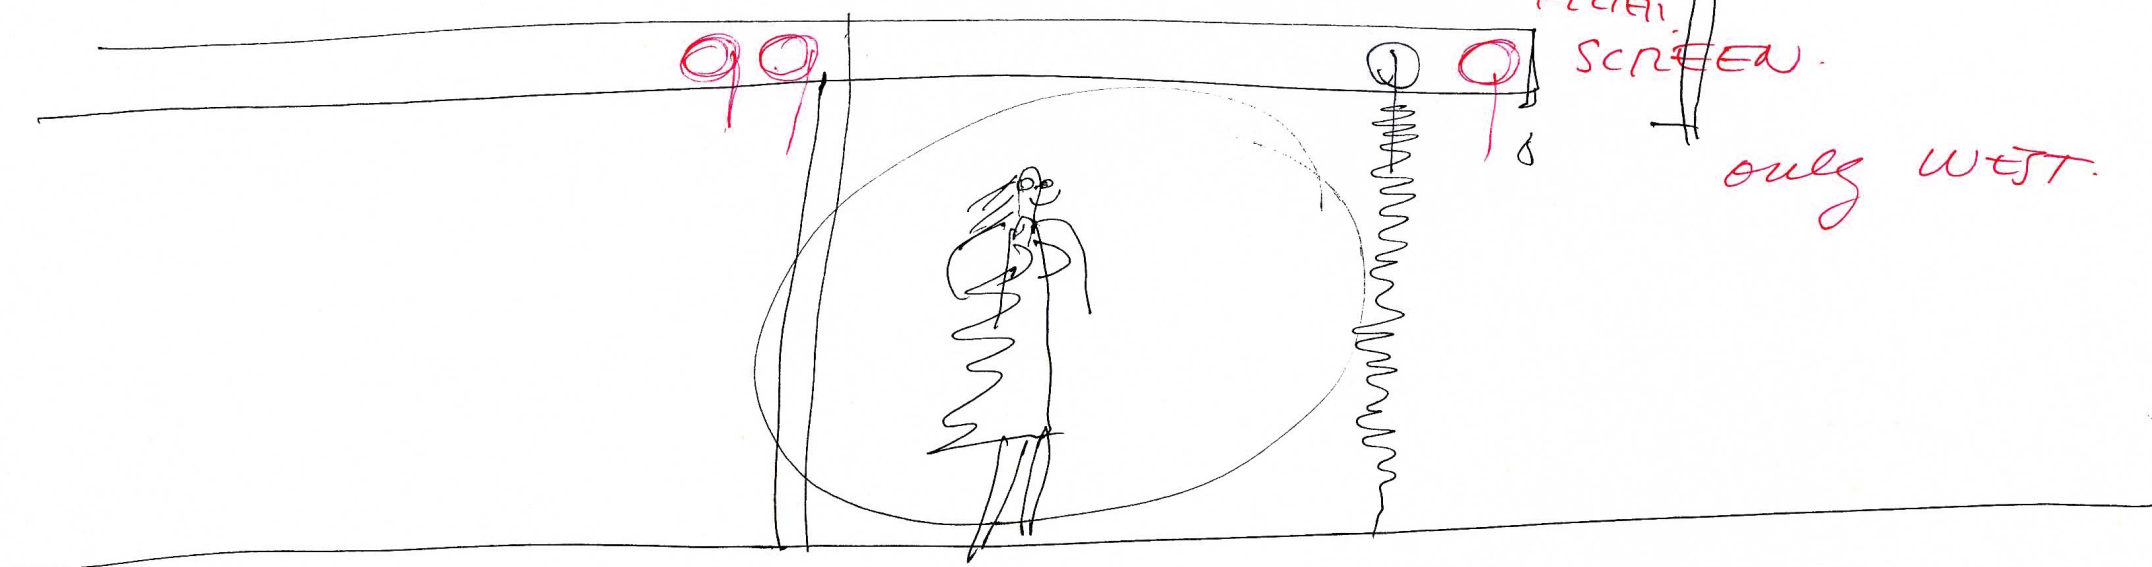



@ can specification! LARSEN

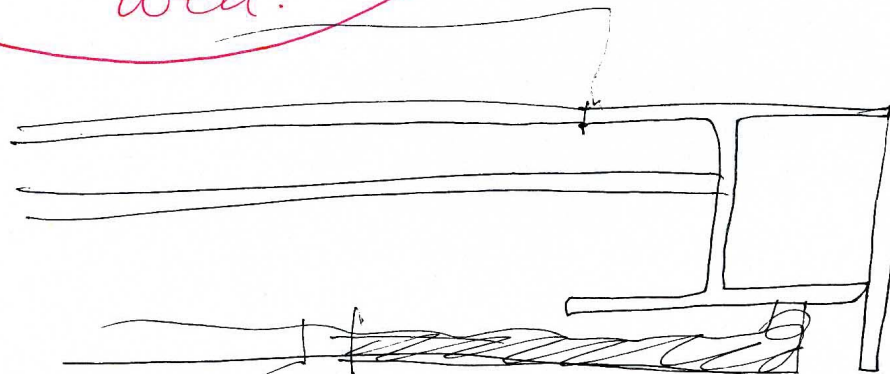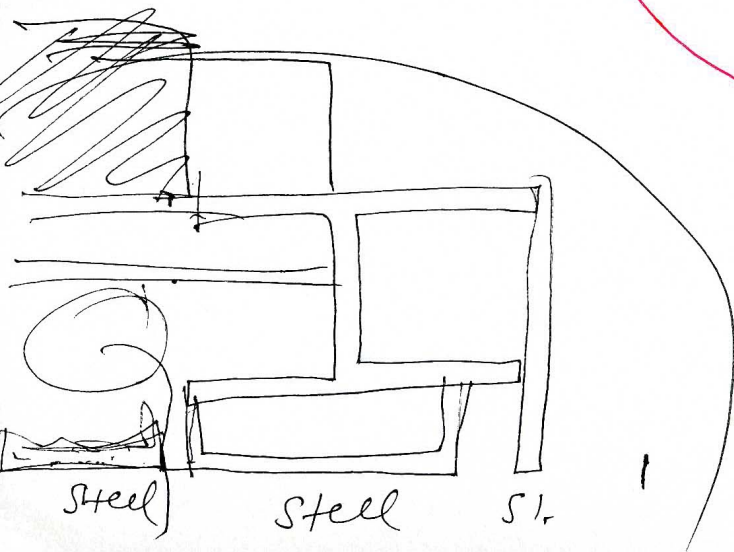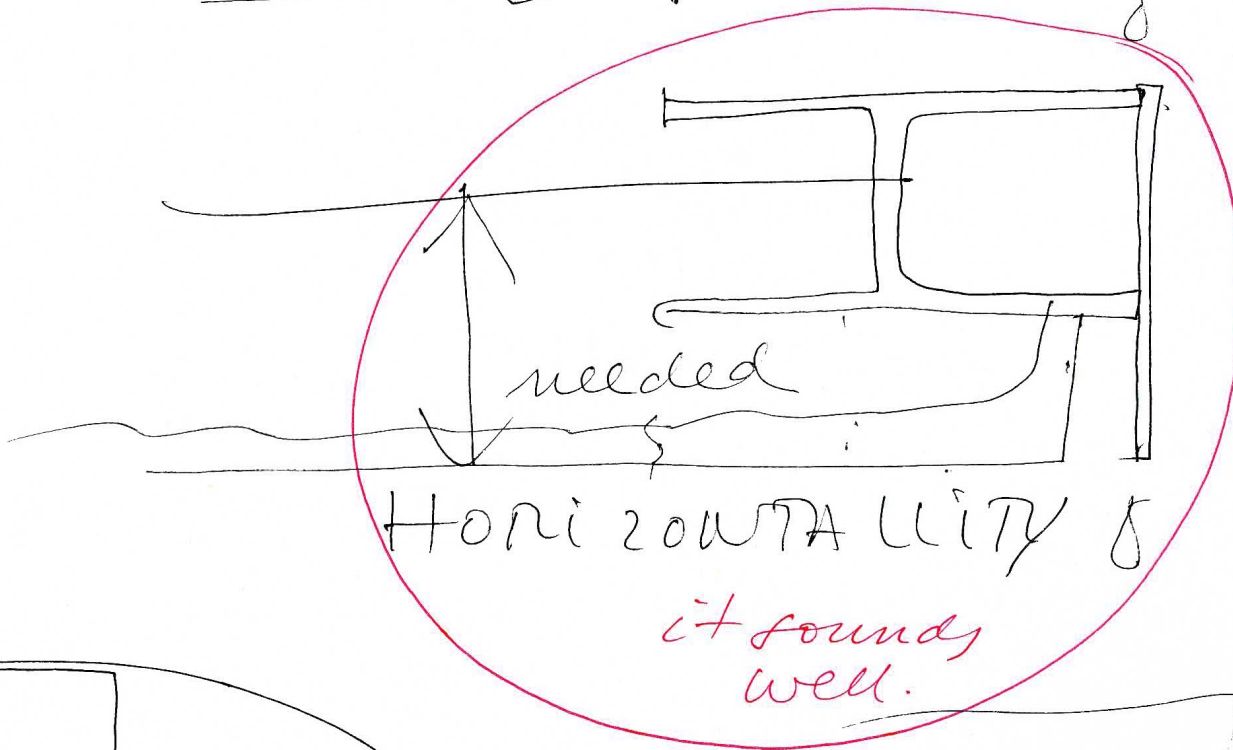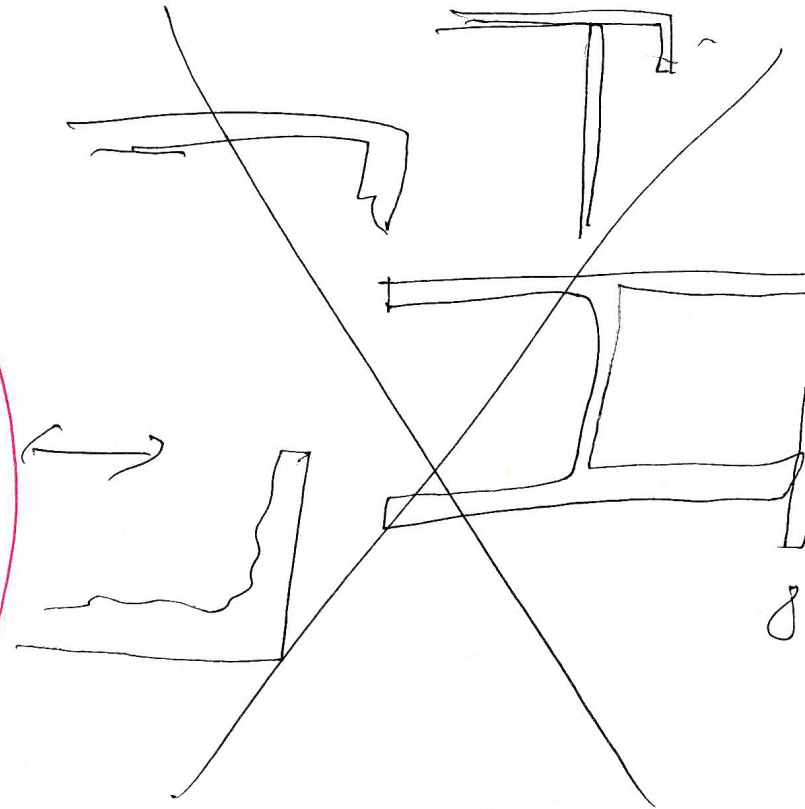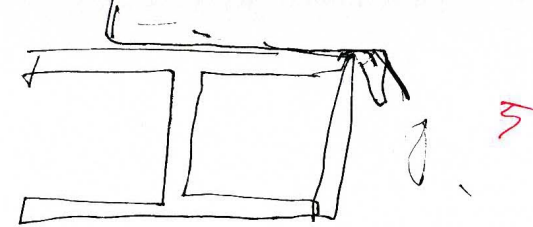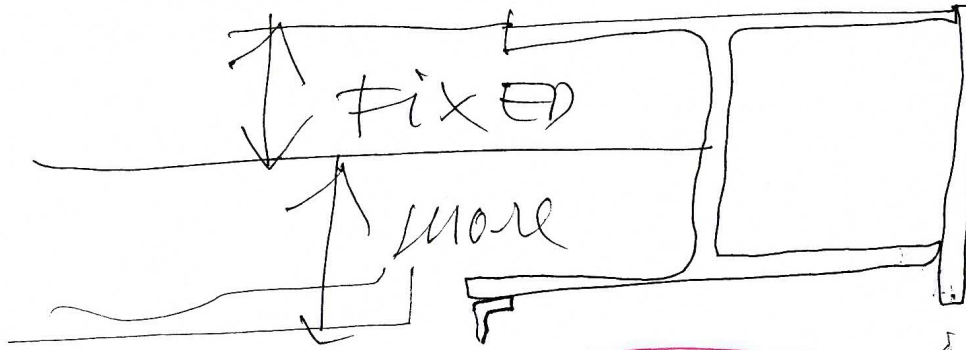

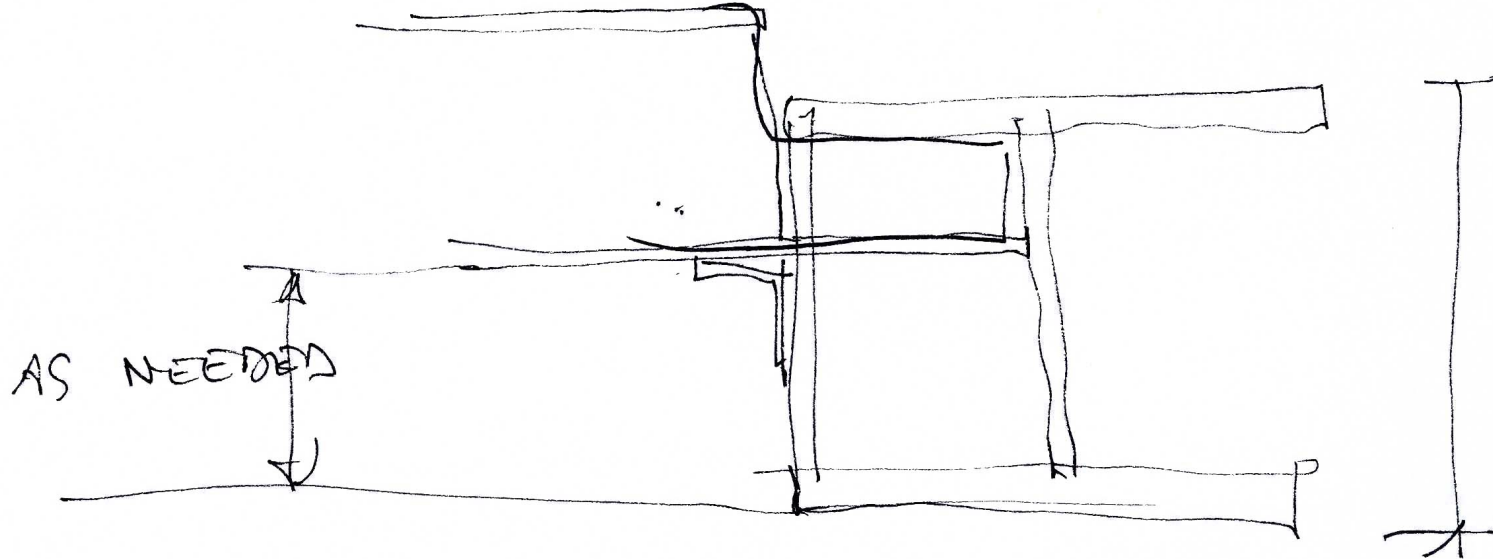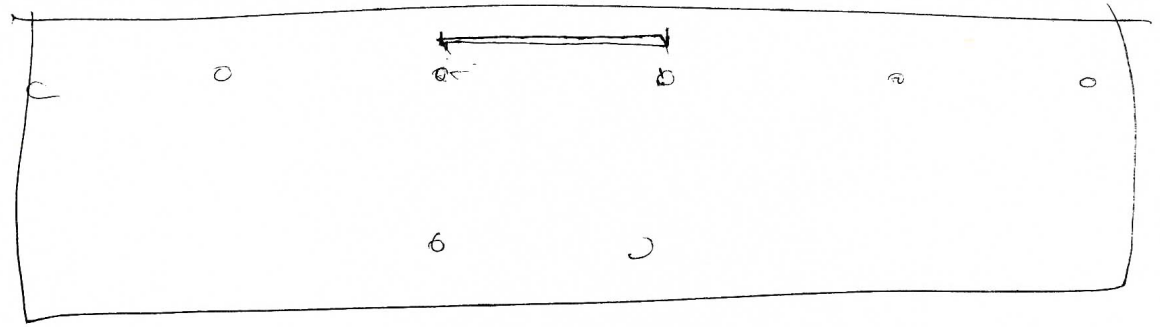


laser
vertical

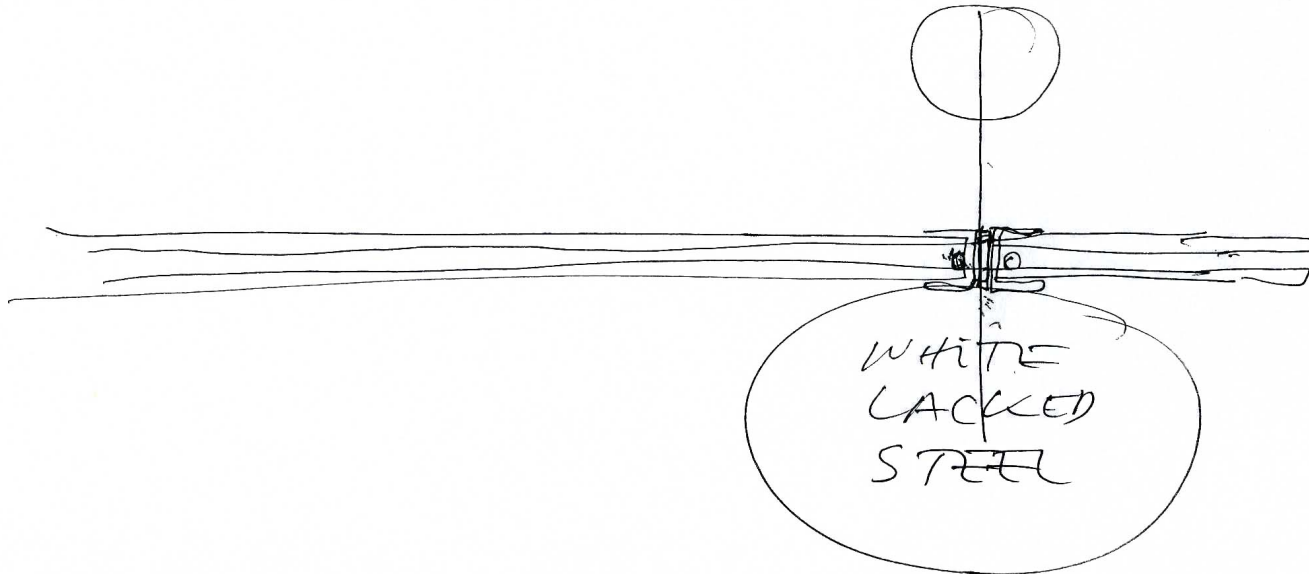

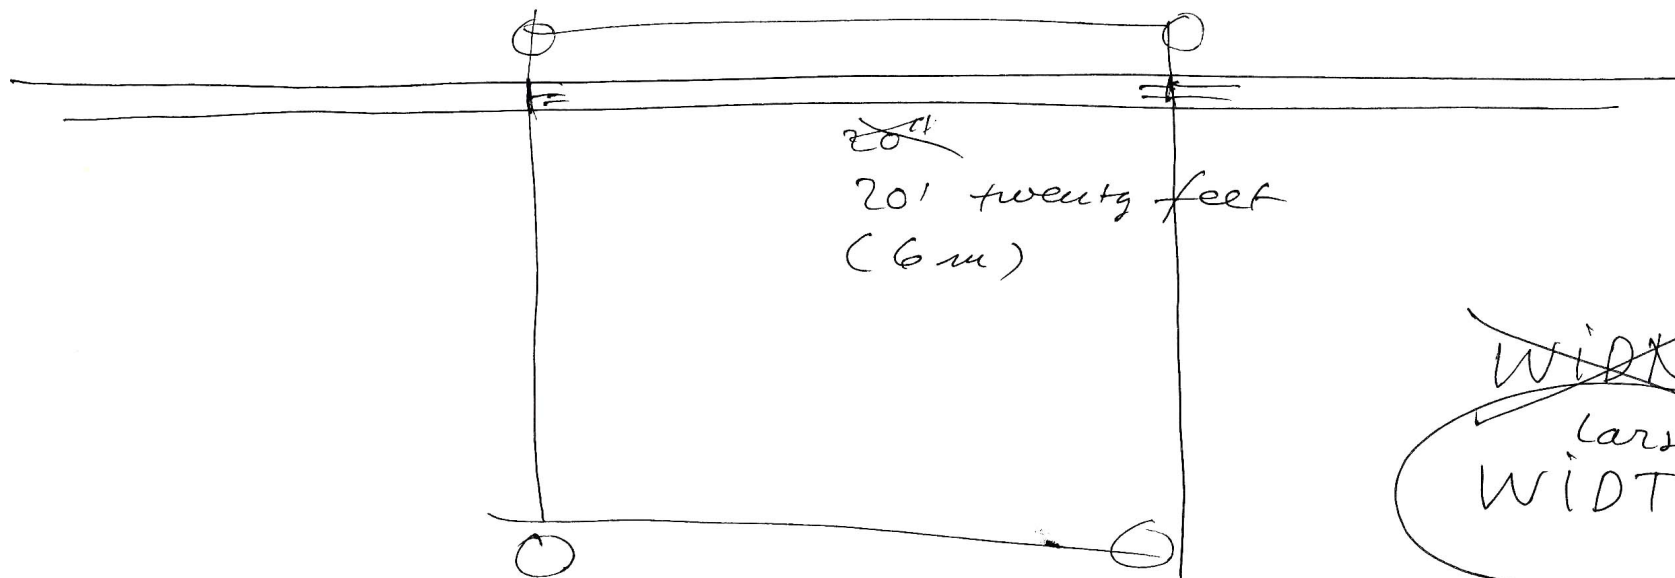


~~width~~
larger
width

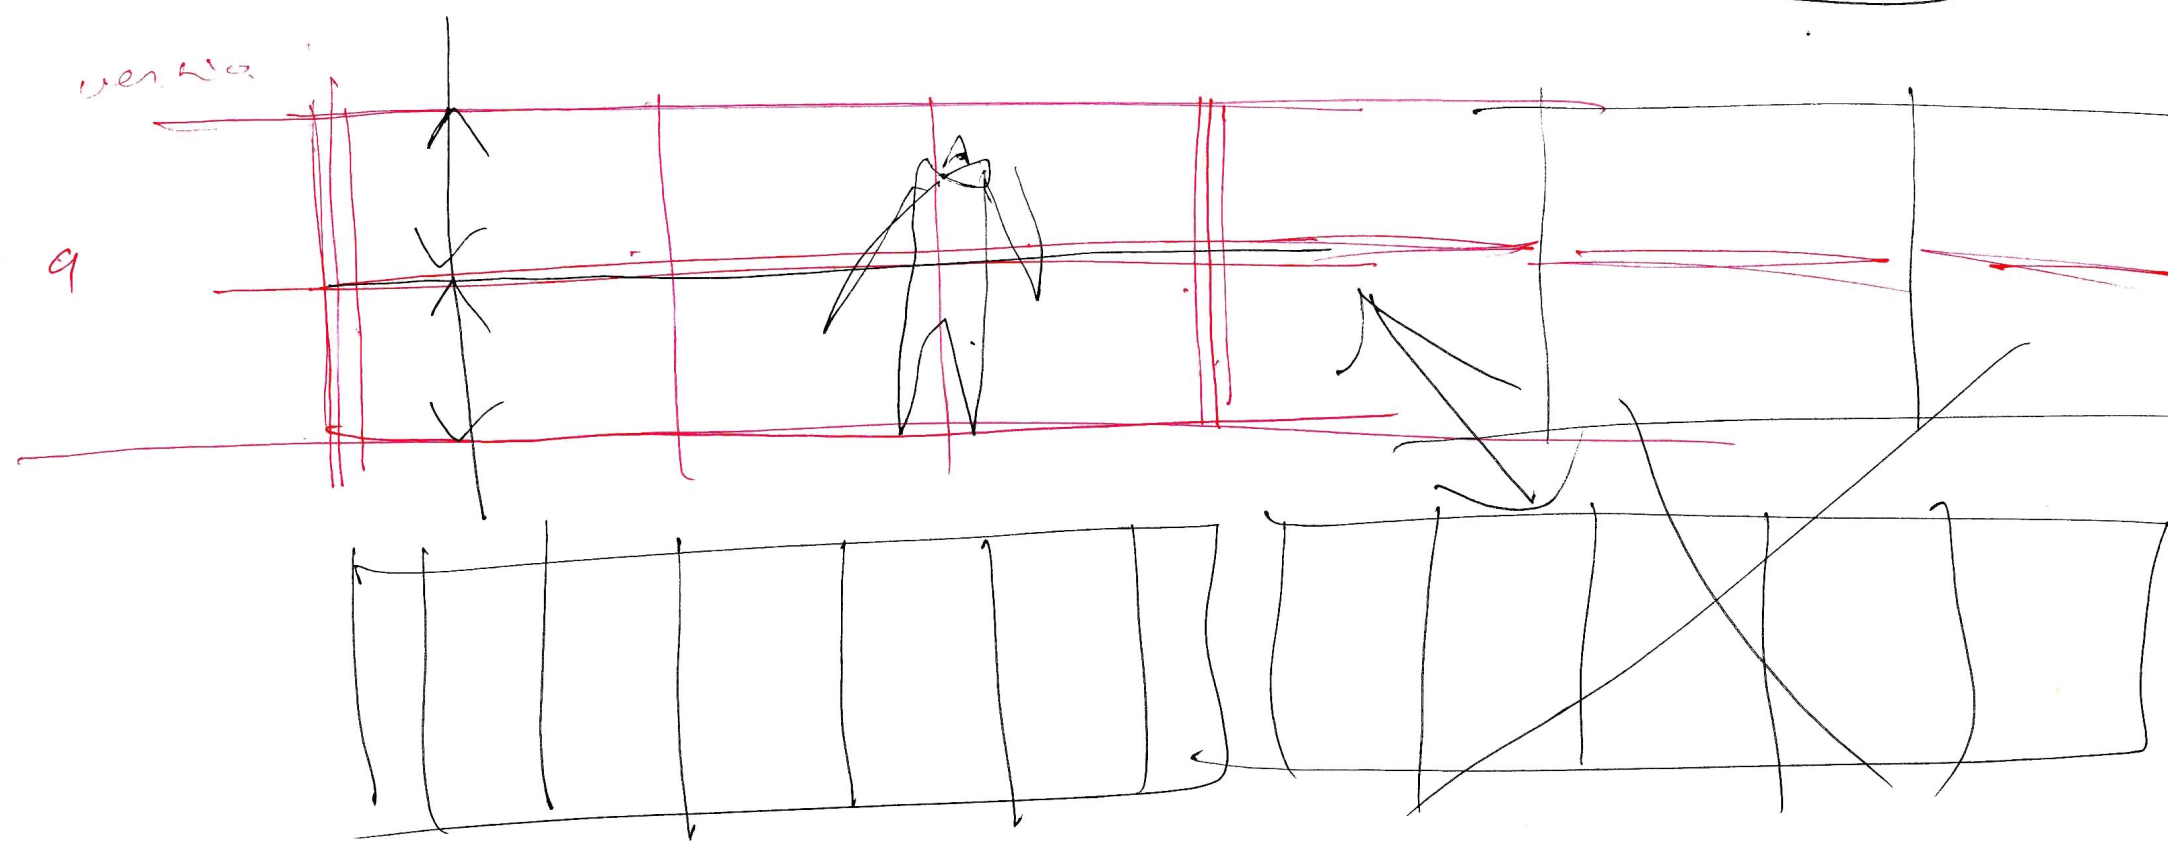

ITEM 2.

8

Asencio's ~~Design~~ PRE DRAINAGE

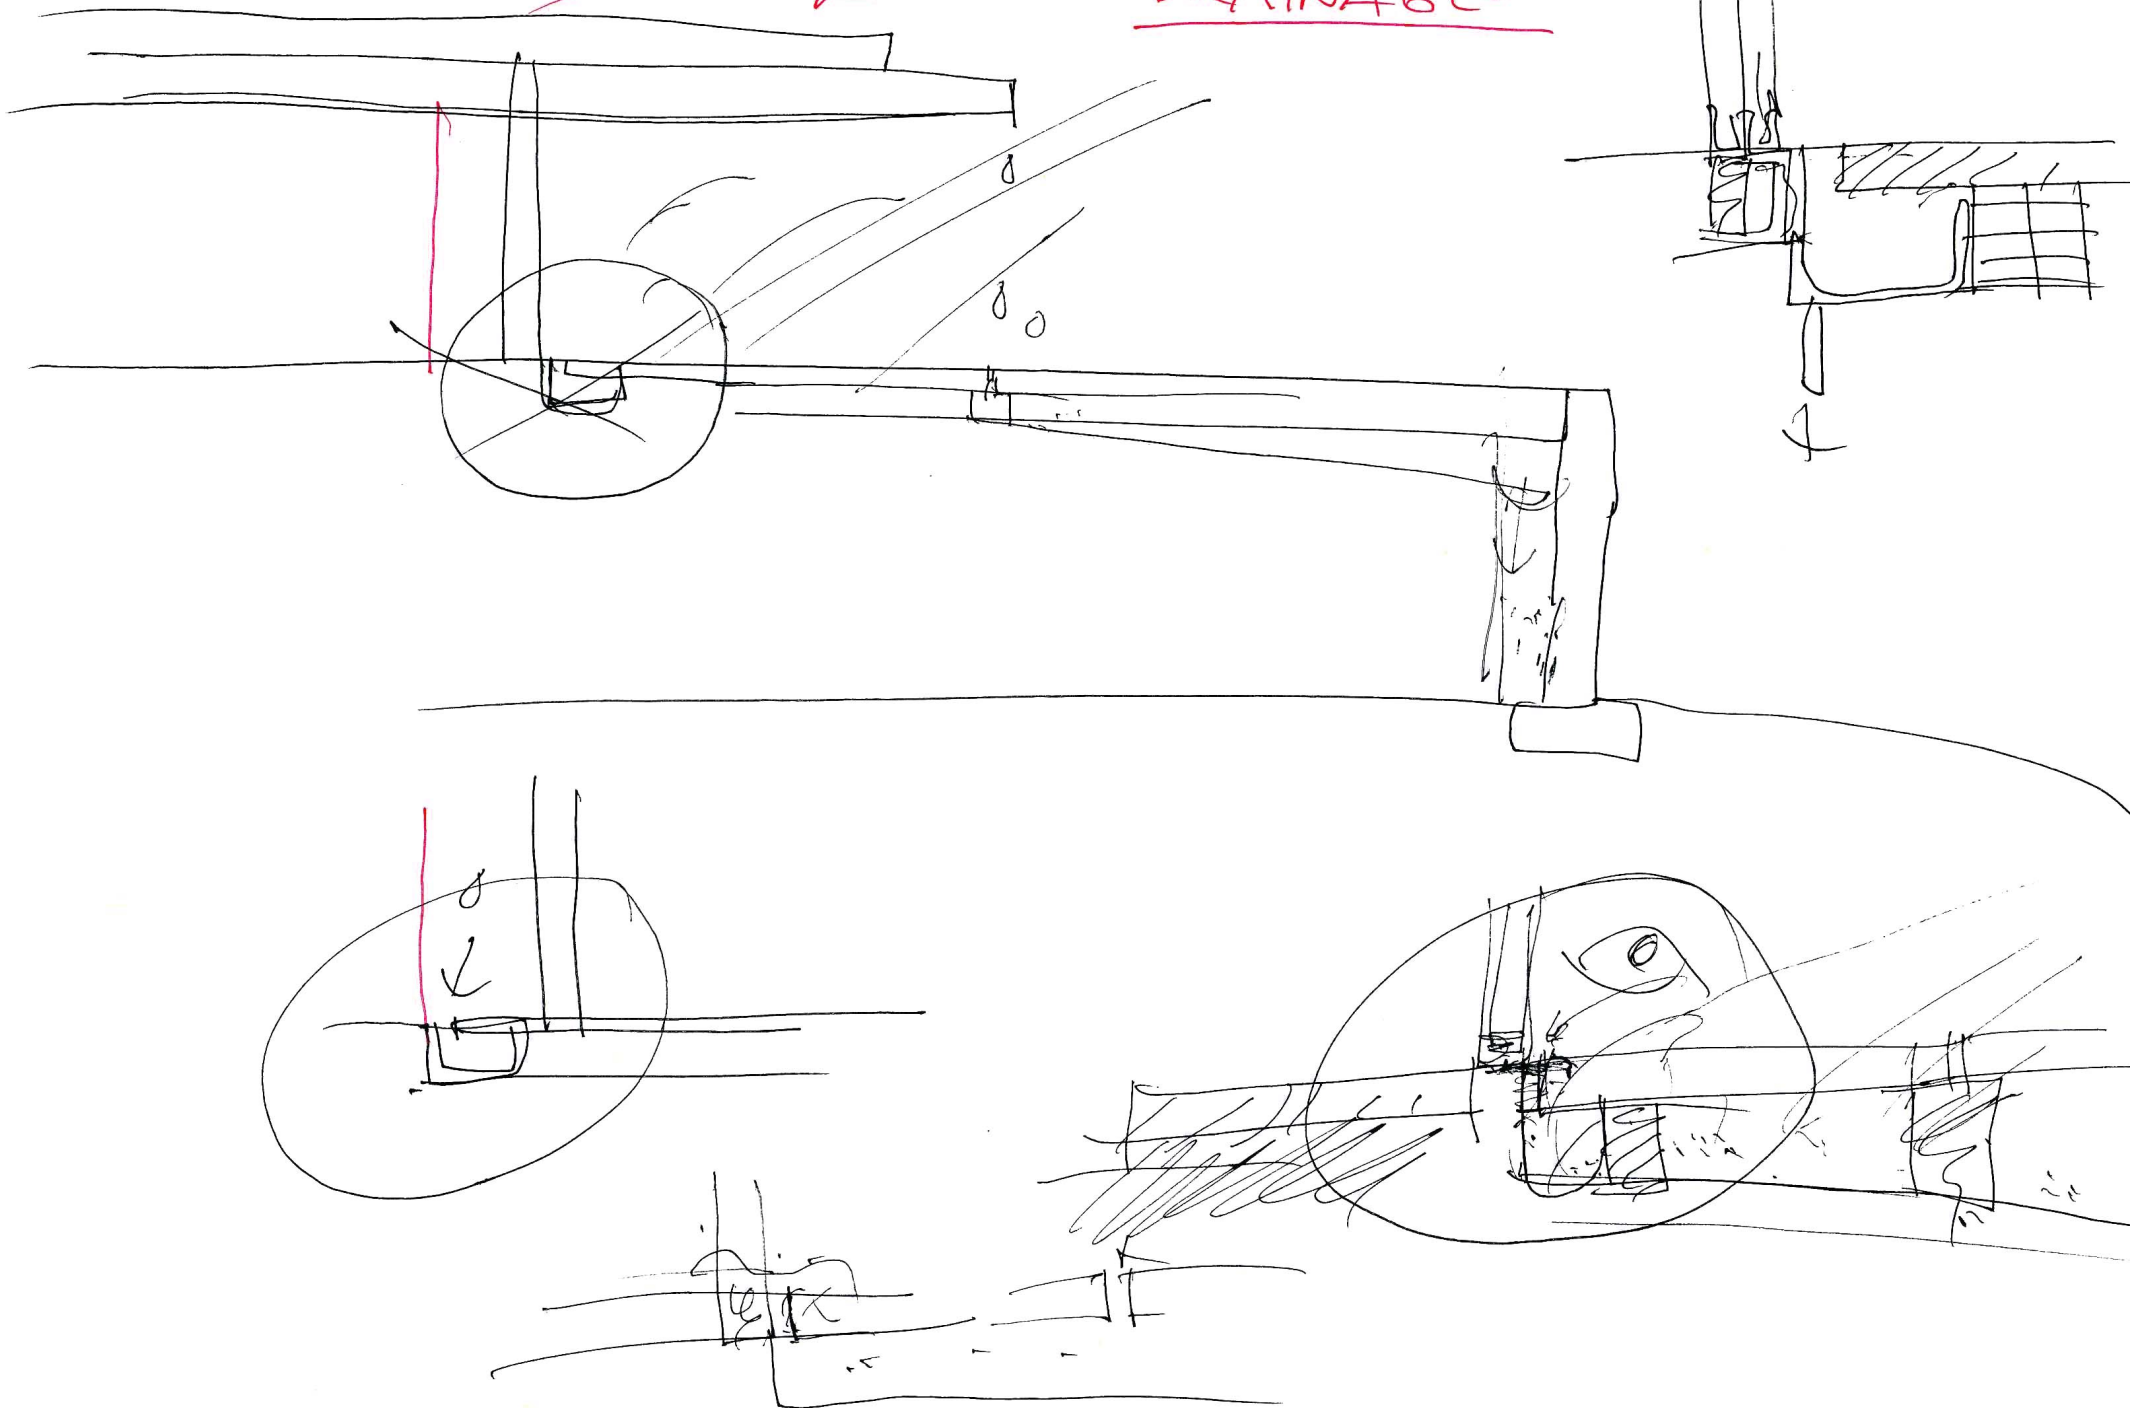

ITEM 3
little hot travertine

OLNICK SPANU
@ dealer's
few
Carbonyl

